
PLAN OF SUBDIVISION

Stage No.	Plan Number
/	PS436937F

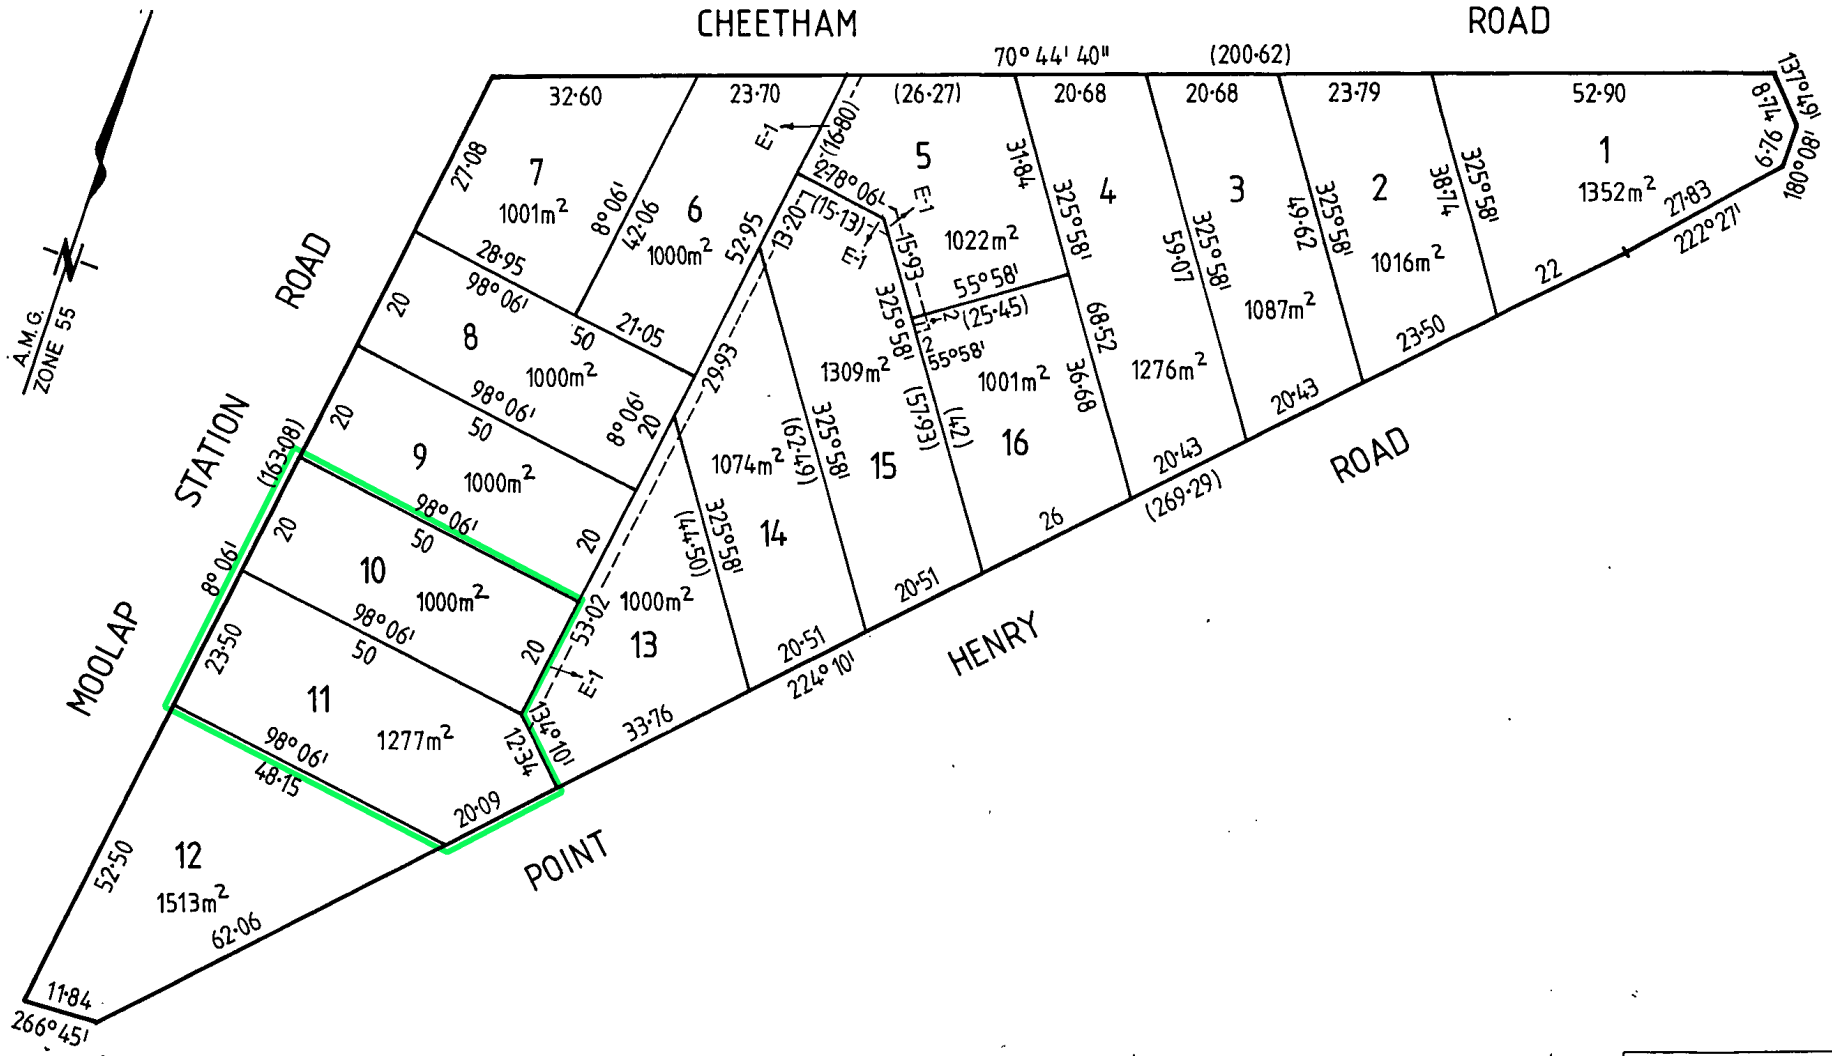

ROD BRIGHT & ASSOCIATES PTY. LTD. LICENSED SURVEYORS 26 MURRAY STREET COLAC 3250 TEL. 5231 4883 A.C.N. 007 206 975	ORIGINAL SCALE 1:800 SHEET SIZE A3	SCALE 8 0 16 32 LENGTHS ARE IN METRES

LICENSED SURVEYOR (PRINT) RODNEY ARTHUR BRIGHT

SIGNATURE ..... DATE 9/9/ 2002

REF 9734 VERSION 2

Sheet 2 of 2 Sheets

DATE / /

COUNCIL DELEGATE SIGNATURE .....

0 10 20 30 40 50 60 70 80 90 100 110 120 130 140 150 mm

TC 3

Delivered by LANDATA®, timestamp 22/09/2026 12:47 Page 2 of 2

City of Greater Geelong, Statutory Planning - Date Received 16/10/2026